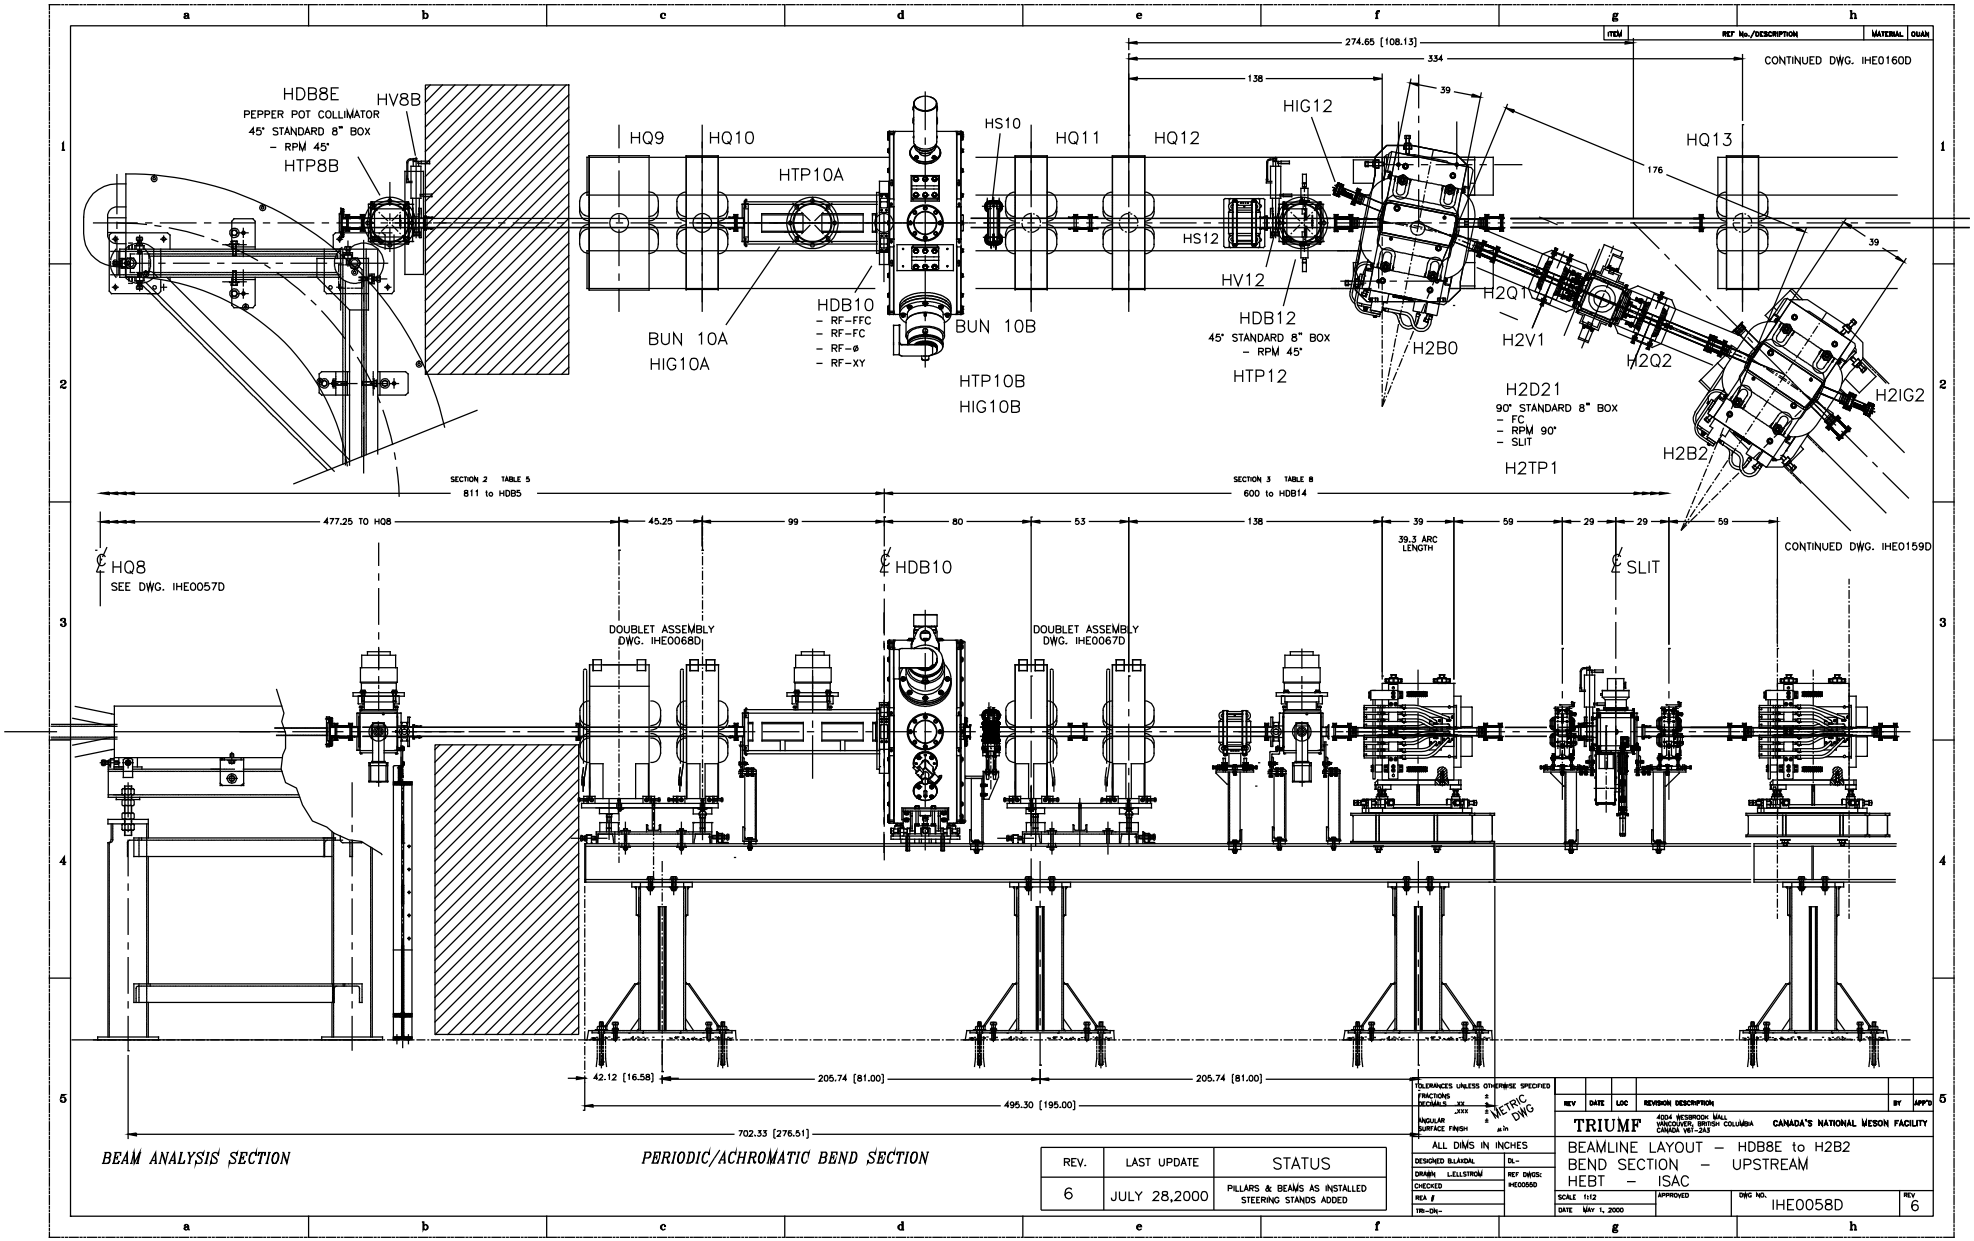

REV.	LAST UPDATE	STATUS
6	JULY 28,2000	PILLARS & BEAMS AS INSTALLED STEERING STANDS ADDED

ITEM | REF No./DESCRIPTION | MATERIAL | QUAN

TOLERANCES UNLESS OTHERWISE SPECIFIED
FRACTIONS ±
DECIMALS .XX ±
.XXX ±
ANGULAR ±
SURFACE FINISH

METRIC DWG

ALL DIMS IN INCHES

DESIGNED B.LAXDAL
DRAWN L.ELLSTROM
CHECKED
REA ∥
TR–DN–

REF DWGS:
IHE0055D

REV | DATE | LOC | REVISION DESCRIPTION | BY | APP'D

TRIUMF
4004 WESBROOK MALL
VANCOUVER, BRITISH COLUMBIA
CANADA V6T–2A3
CANADA'S NATIONAL MESON FACILITY

BEAMLINE LAYOUT – HDB8E to H2B2
BEND SECTION – UPSTREAM
HEBT – ISAC

SCALE 1:12
DATE MAY 1, 2000
APPROVED
DWG NO. IHE0058D
REV 6